
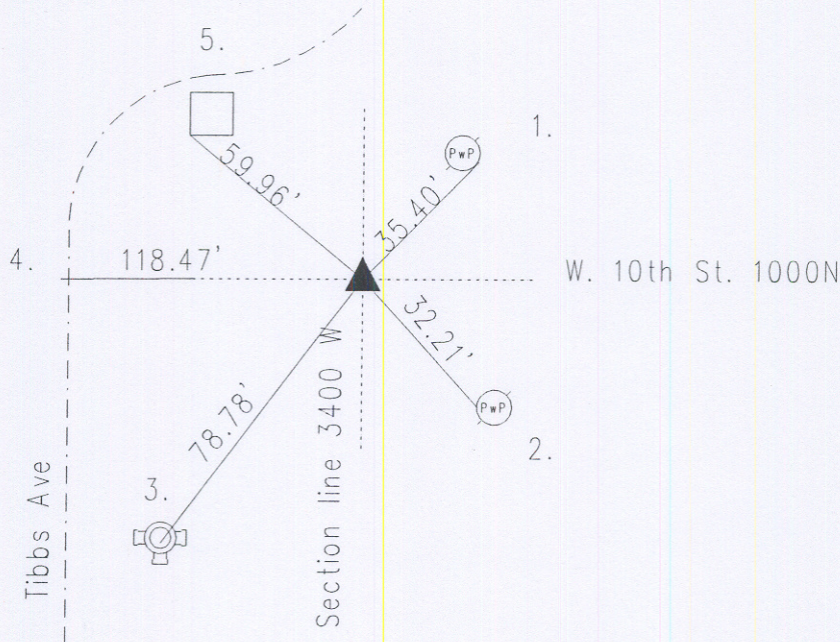


OFFICE OF THE MARION COUNTY SURVEYOR
SECTION RECORD CORNER
SECTION 33 TOWNSHIP 16 RANGE 3
DATE: 10-09-08
PARTY CHIEF: Wilcoxon
CREW: _____
TYPE OF MARKER: Harrison Monument
METHOD OF ESTABLISHMENT: County: 8-31-06

IN. S.P.C. E ZONE NAD '83
NAME: 16033307
N: 503292.7380(m)
E: 52966.1540(m)

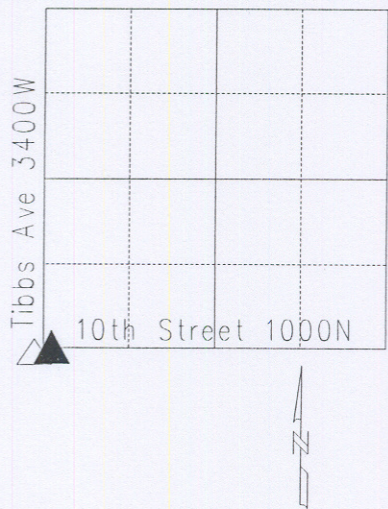

Corner History: Corner reference with witness per Marion County 1883 Atlas page 7; 20" buckeye S 67 E 33 links; 18" sugar maple N 55 W 27 links. Survey by Fatout dated 6-4-1879 per Wayne Township Legal Survey Book 1, ppage 67. No reference recorded in the 3"x5" tie cards. Corner reference dated 1-4-76 by Miller called PK nail. Corner reference dated 2-16-90 by Wilcoxon called PK nail found. Corner reference dated 8-12-96 by Wilcoxon called PK nail fd. Corner reference dated 6-10-01 by Whiteside called pk nail found. Corner reference dated 10-9-08 by Wilcoxon. Set Harrison monument per GPS coordinates, no other points found because of old trolly tracks.

16033307

REF.	DISTANCE	DESCRIPTION
1.	35.40'	PK nail E PwP no# 6"up
2.	32.21'	Mag nail w/bw W PwP#465-500B 10"up
3.	78.78'	Top nut of fire hydrant
4.	118.47'	Due W to pk nail
5.	59.96'	SW corner of concrete base for signal box